




Integrated Water Resource Management Phase 2 Kharas Wastewater Treatment Plant

REF. NO: From Abeer

Rehabilitation and Partitioning of Aeration Tank Draft Design Drawings



2025

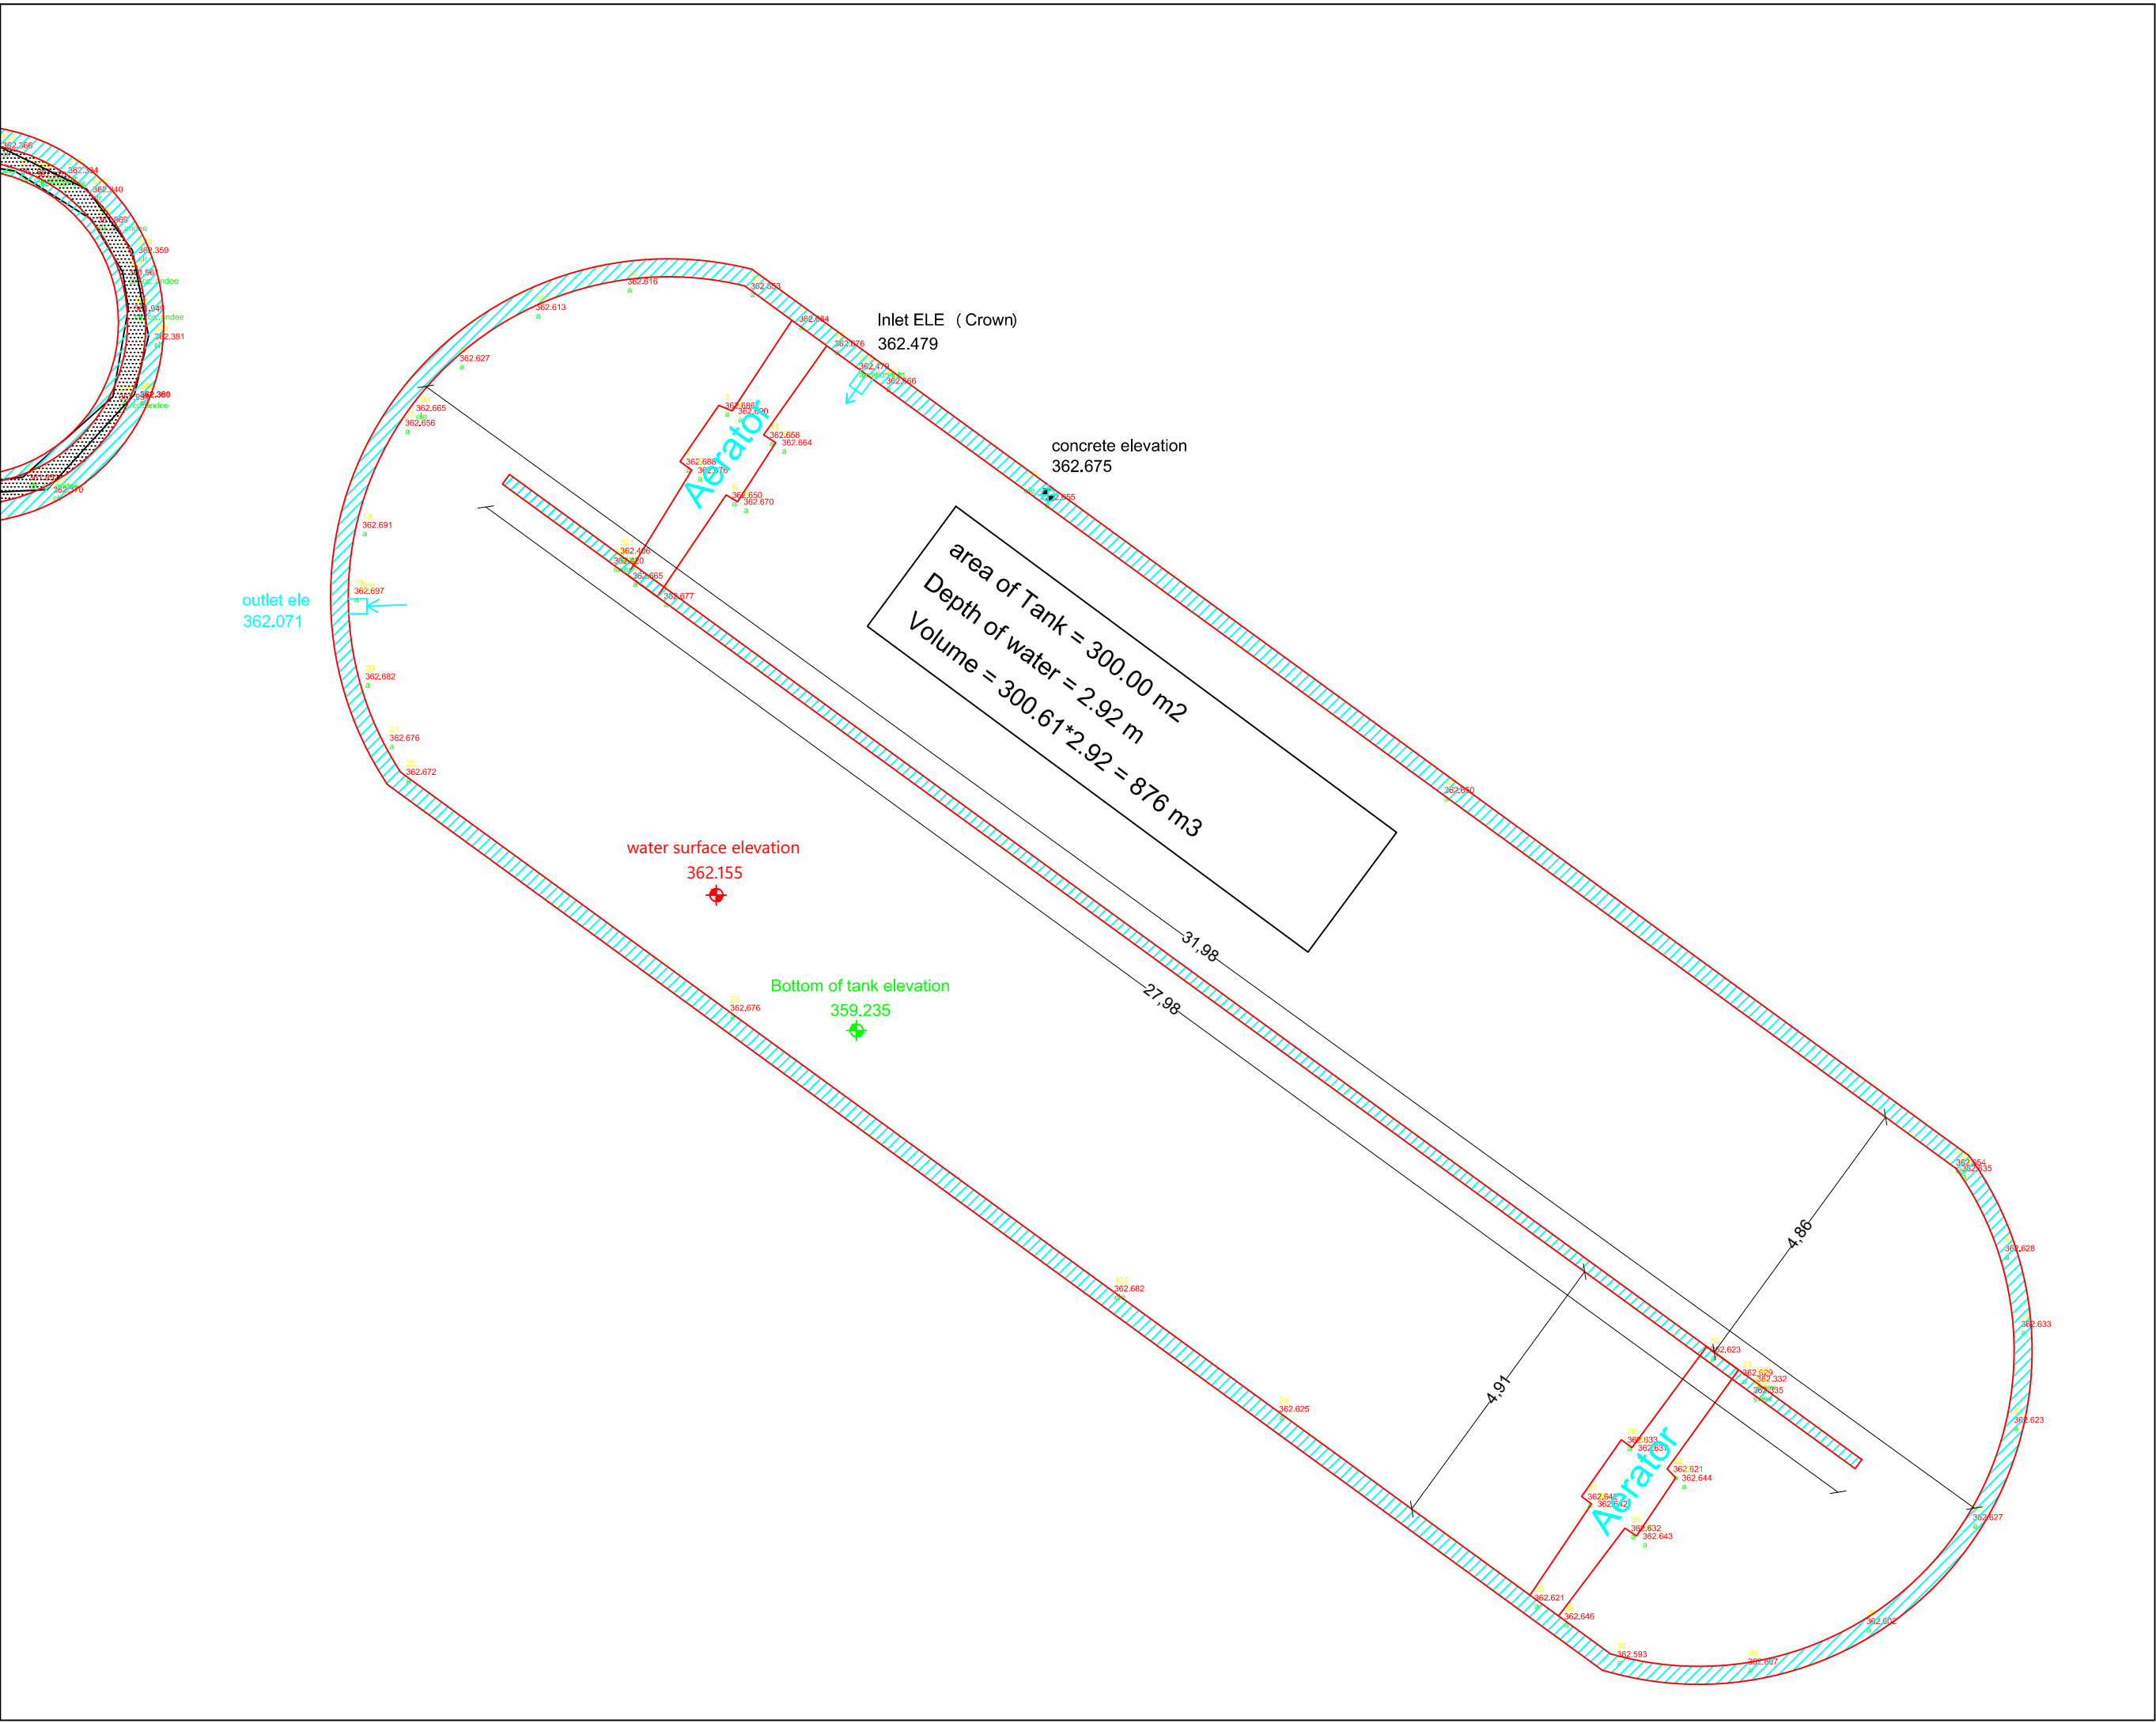

Drawing Name:
Kharas WWTP As Built Aeration Tank

Drawing No.:
KH-EXP-AI- AR-01

Grid:
Palestine 1923 Palestine Grid

Scale:
A3

Date:
June, 2025

REV	Date	Description	Drawn	Design	Checked	Approved By
1	June 2024	Draft Preliminary Design	H Dababat			

Integrated Water Resource Management Phase 2
RFP REF. NO: From Abeer
Rehabilitation and Partitioning of Aeration Tank – Kharas WWTP


Experts-Solidaire
Expert Solidaires
Bâtiment B1, Parc Scientifique II
Agriculture 2116 Boulevard de la Libération

AIAI for Agricultural Development
Sahel Numidia street, HITECH building
Ramallah-Palestine

In Association With

CLIENT:

Notes:

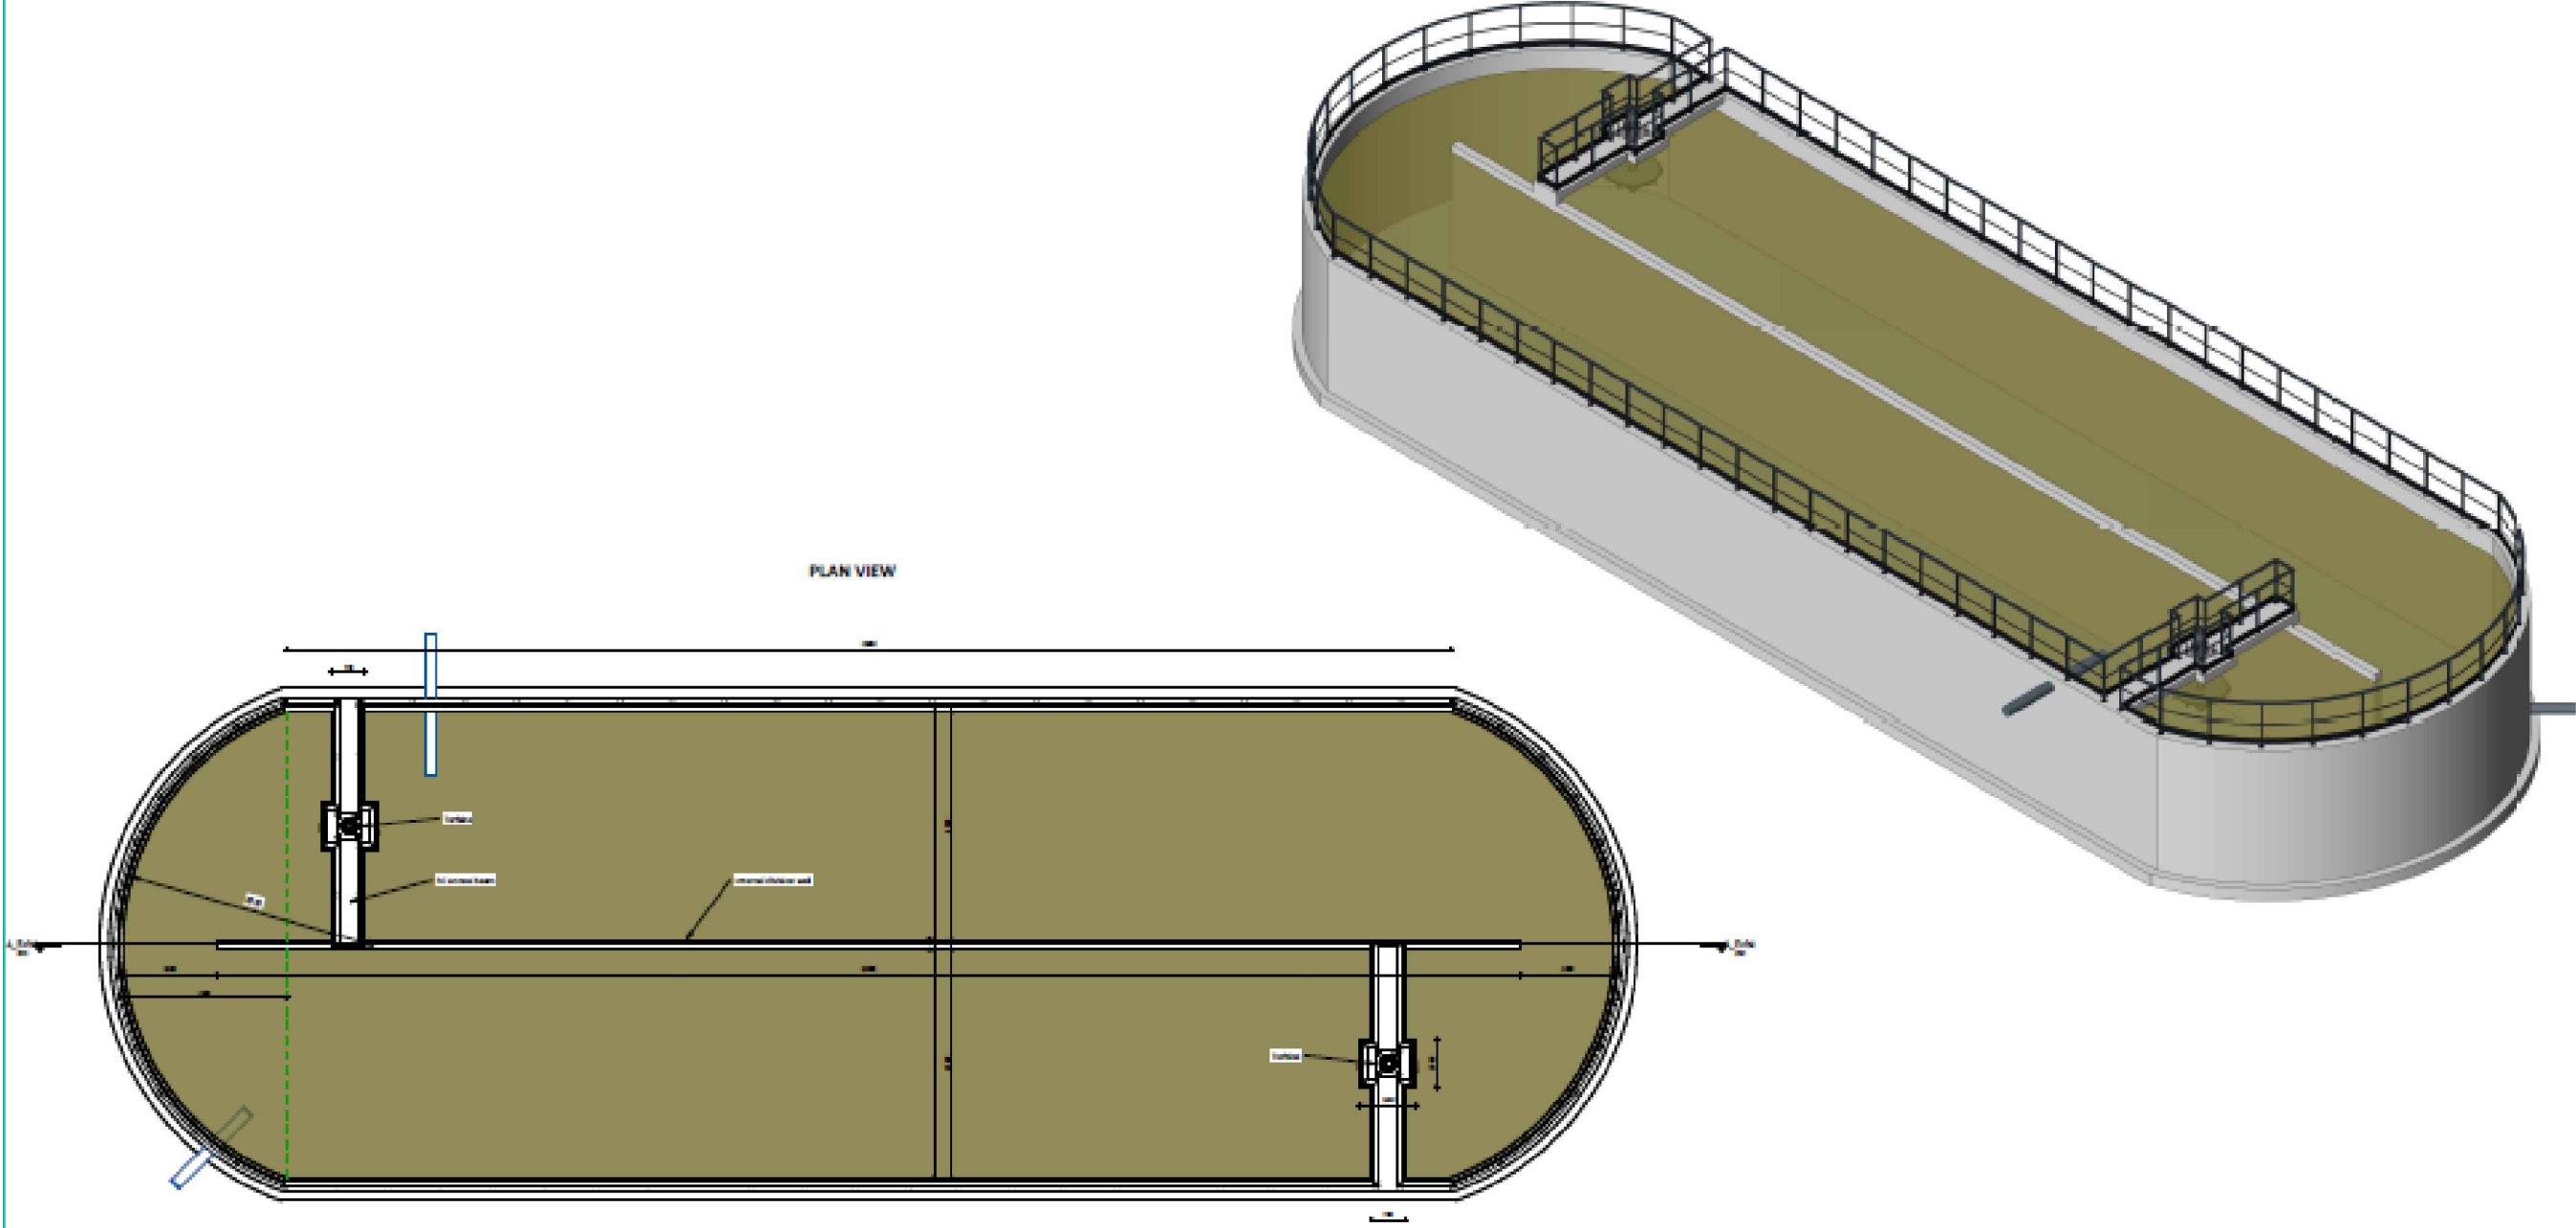

Drawing Name.

Kharas WWTP 3D Shots As Built Aeration Tank

Drawing No.

KH-EXP-AI- AR-02

Date:

June, 2025

Grid

Palestine 1923 Palestine Grid

Scale

A3

Size

REV	Date	Description	Drawn	Design	Checked	Approved By
1	June,2024	Draft Preliminary Design	H.Dababat			

CLIENT:



Integrated Water Resource Management Phase 2
RFP REF. NO: From Abber
Rehabilitation and Partitioning of Aeration Tank – Kharas WWTP


Supervision:

AI Aid for Agricultural Development
Sahh Numeida street, Hitech building
Ramallah-Palestine

In Association With

Experts-Solidaires
Expert Solidaires
Bâtiment B1, Parc Scientifique II
Agriculture 2186 Boulevard de la Croix

Notes:

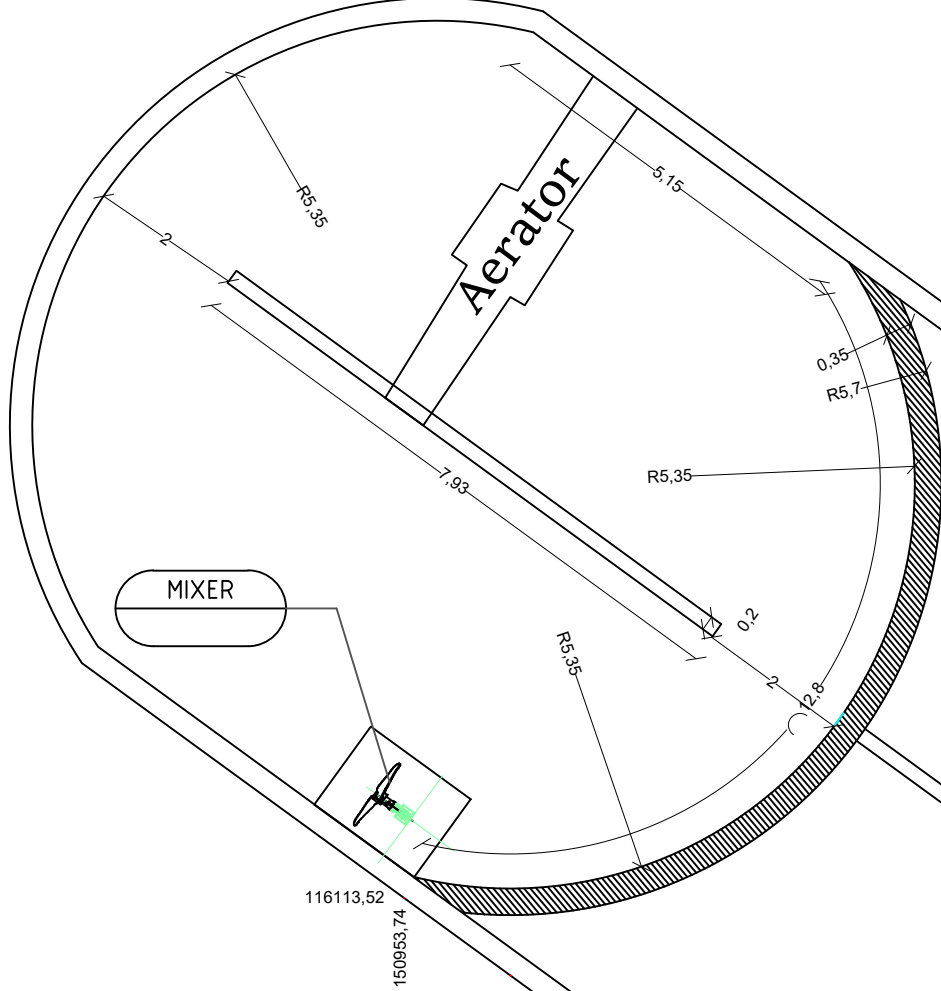

Aerator

Total
Area
=100 m2

Drawing Name.

Kharas WWTP New Proposed Design

Drawing No.

KH-EXP-AI-AR-03

Date:

June, 2025

Grid

Palestine 1923 Palestine Grid

Scale

A3

Size

A3

REV	Date	Description	Drawn	Design	Checked	Approved By
1	June,2024	Draft Preliminary Design	H.Dababat			

CLIENT:



Integrated Water Resource Management Phase 2

RFP REF. NO: From Abeer

Rehabilitation and Partitioning of Aeration Tank – Kharas WWTP

Supervision:


AI And for Agricultural Development
Sahh Mumaba street, Hfitch building
Ramallah-Palestine

In Association With

Experts-Solidaires
Expert Solidaires
Bâtiment B1, Parc Scientifique II
Agriculture 2186 Boulevard de la Lronda

Notes:

SECTION 01

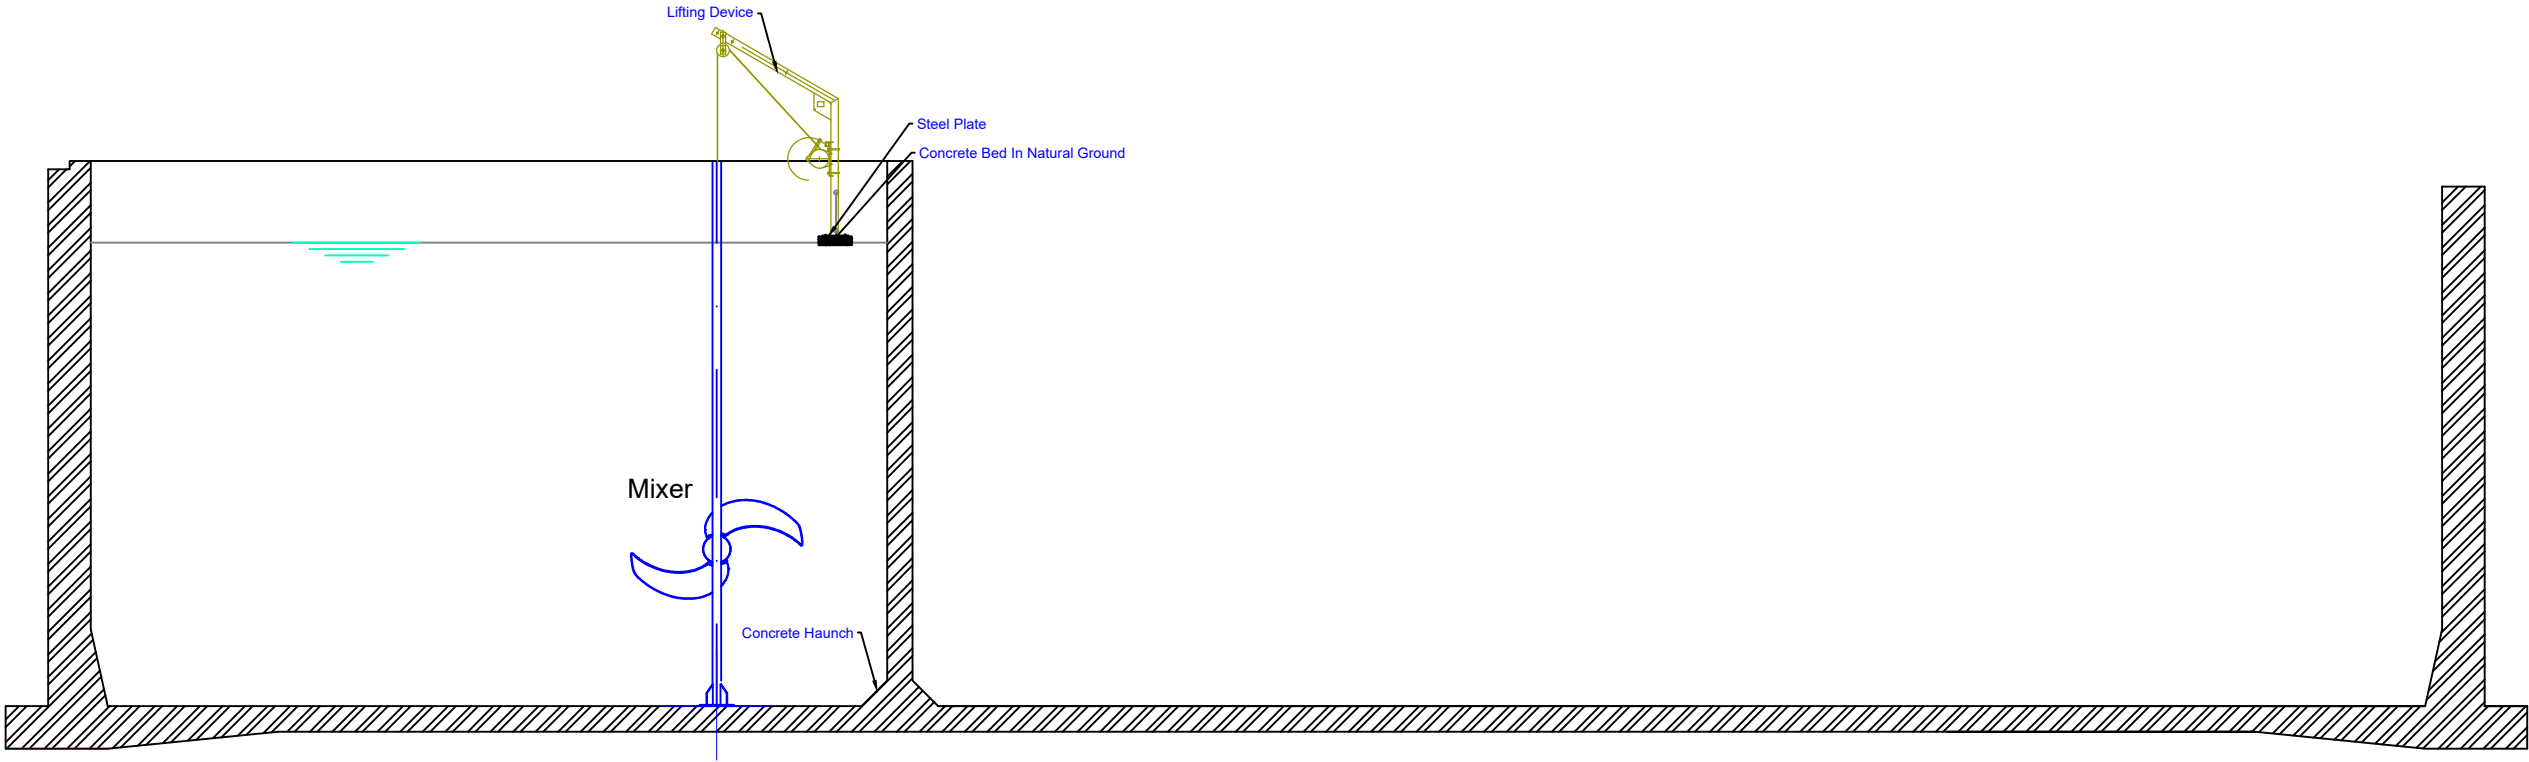

Drawing Name.

Kharas WWTP-Mixer Details- Proposed Design

Drawing No.

KH-EXP-AI- AR-05

Date:

June, 2025

Grid

Palestine 1923 Palestine Grid

Scale

Size

A3

REV	Date	Description	Drawn	Design	Checked	Approved By
1	June,2024	Draft Preliminary Design	H.Dababat			

CLIENT:



Integrated Water Resource Management Phase 2

RFP REF. NO: From Abber

Rehabilitation and Partitioning of Aeration Tank – Kharas WWTP

Supervision:




AI Aid for Agricultural Development
Sahel Nemaha street, H/Tech building
Ramallah-Palestine

In Association With



Experts-Solidaires
Bâtiment B1, Parc Scientifique II
Agriculture 2186 Boulevard de la Lorraine

Notes:

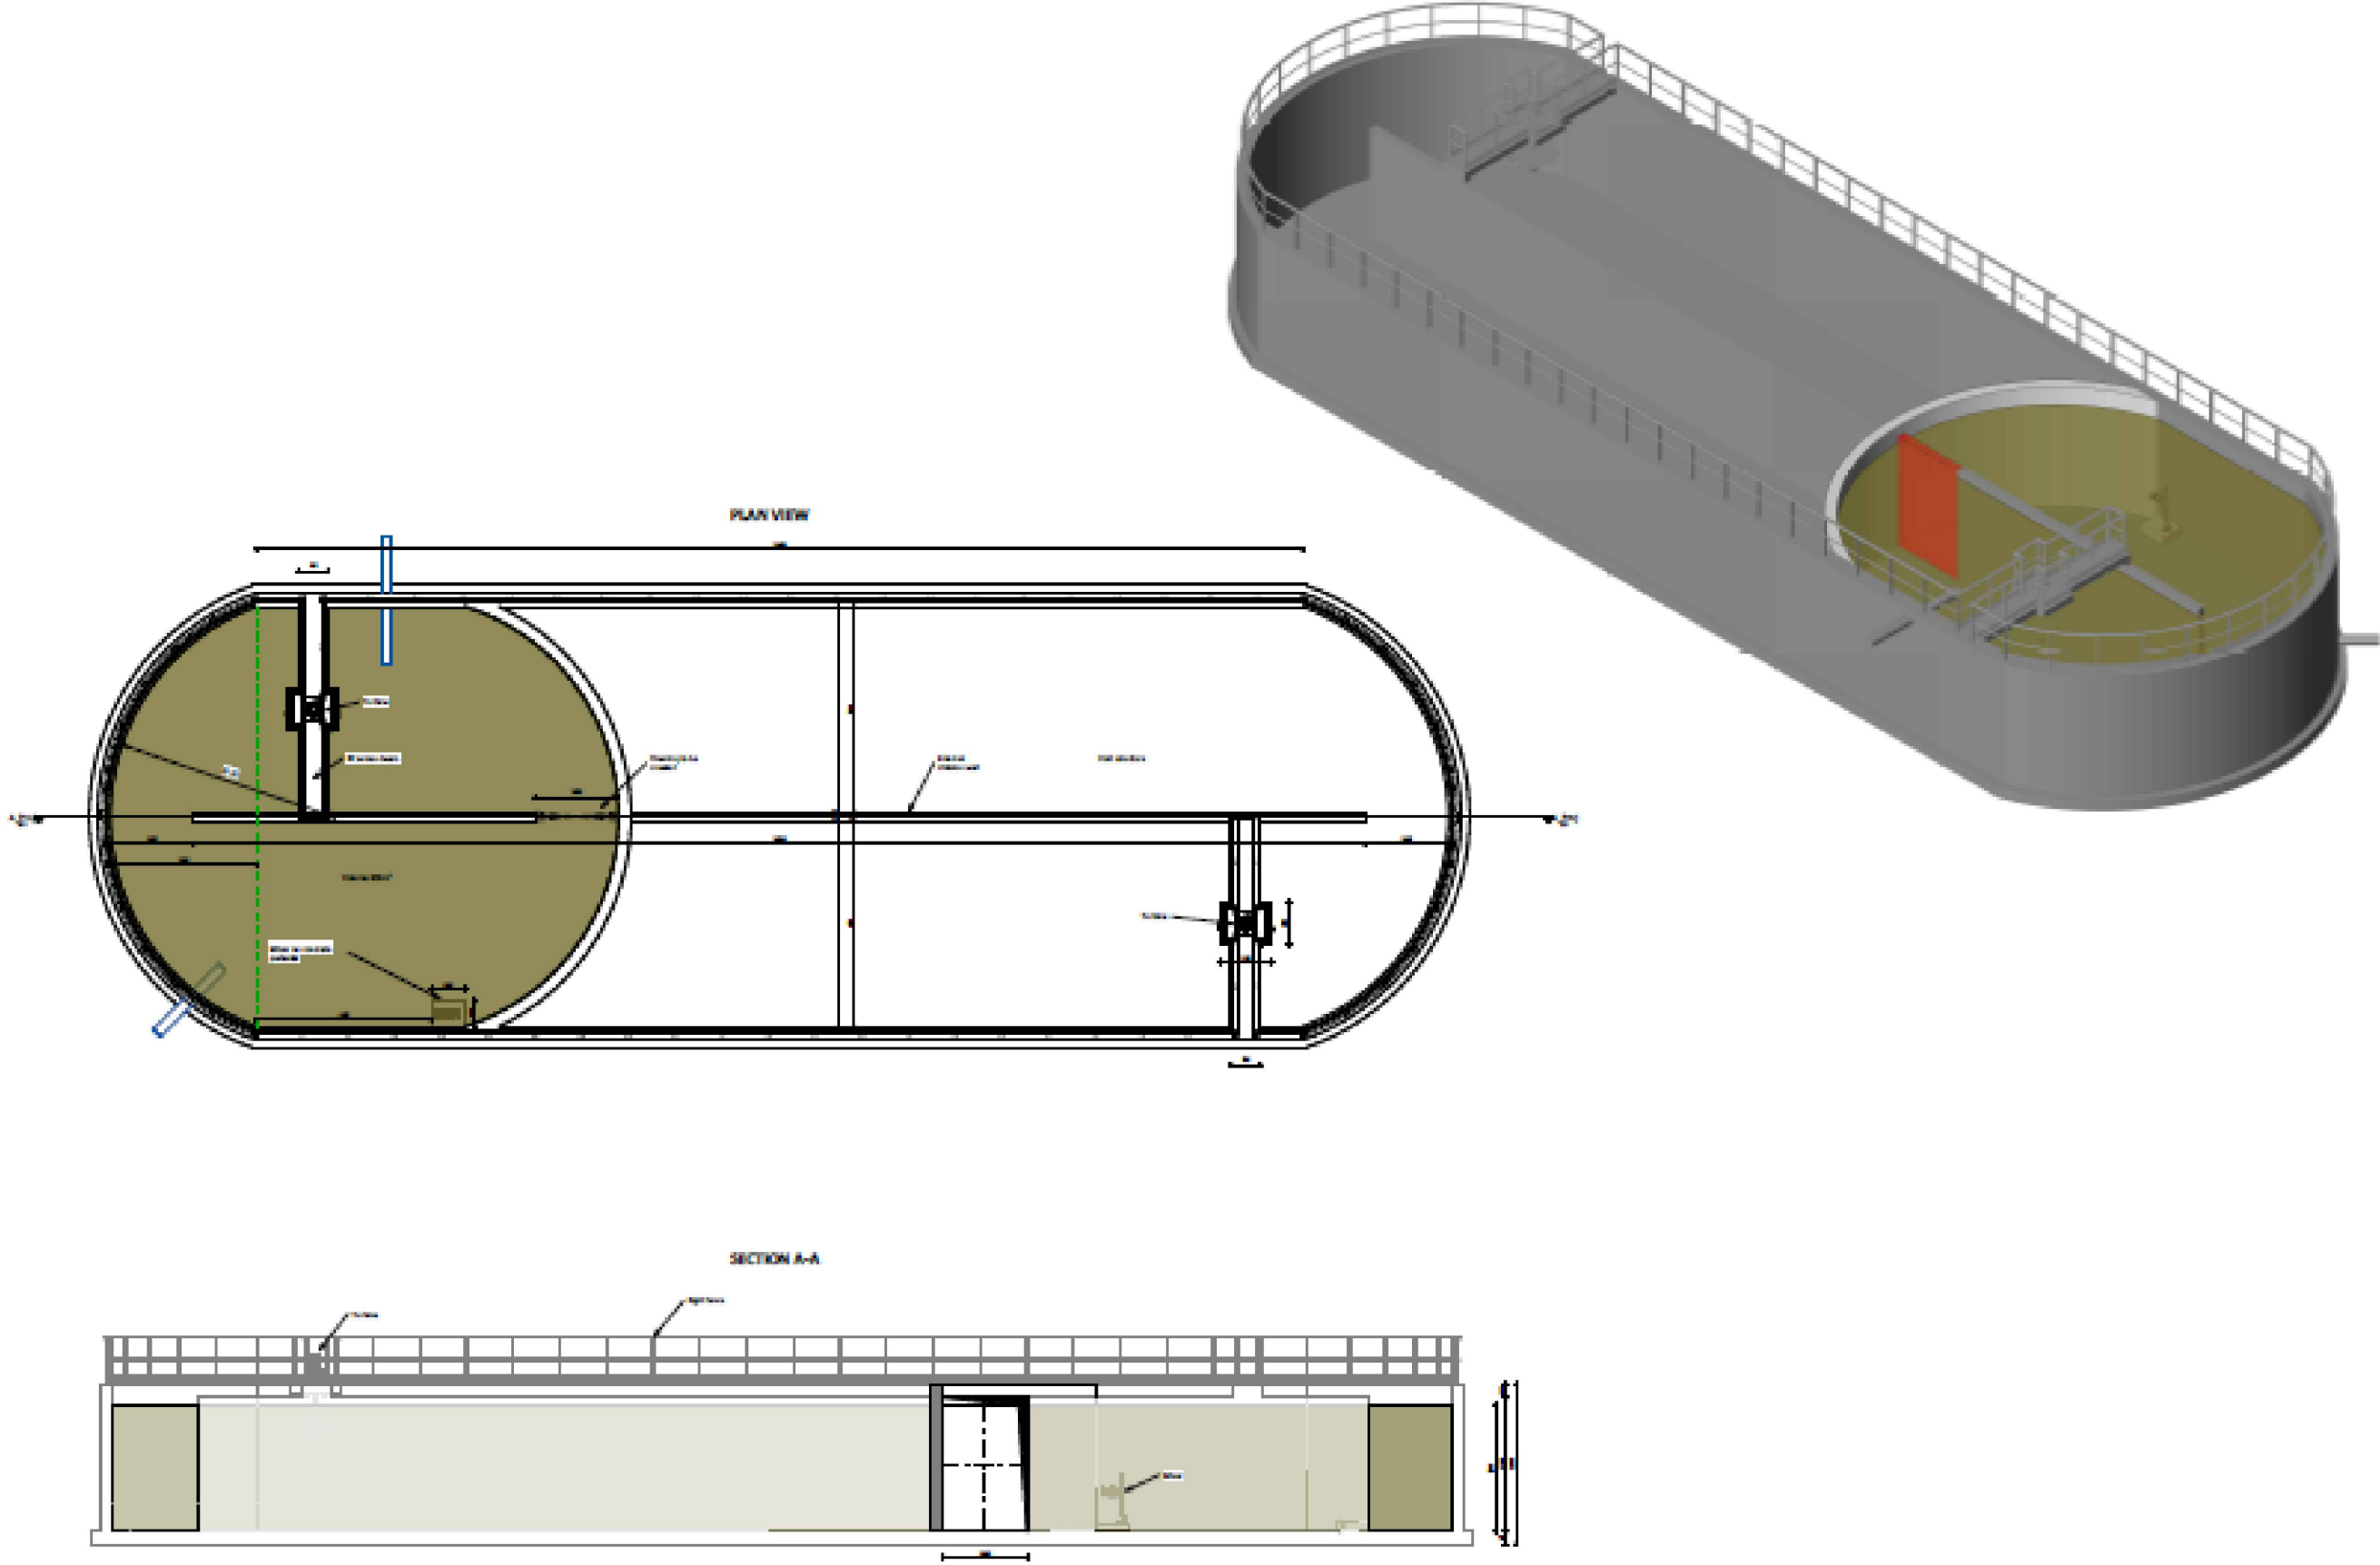

Drawing Name.

KHARAS WWTP 3D-SHOOT

Drawing No.

KH-EXP-AI-AR-04-A

Date:

June, 2025

Grid

Palestine 1923 Palestine Grid

REV

1

June, 2024

Date

Description

Draft Preliminary Design

Drawn

H. Dababat

Design

Checked

Approved By

CLIENT:



Integrated Water Resource Management Phase 2

RFP REF. NO: From Abber

Rehabilitation and Partitioning of Aeration Tank – Kharas WWTP

Supervision:




AI And for Agricultural Development
Sahh Numeida street, Hitech building
Ramallah-Palestine

In Association With




Experts-Solidaire
Expert Solidaires
Bâtiment B1, Parc Scientifique II
Agoopols 2196 Boulevard de la Lronde

Notes:

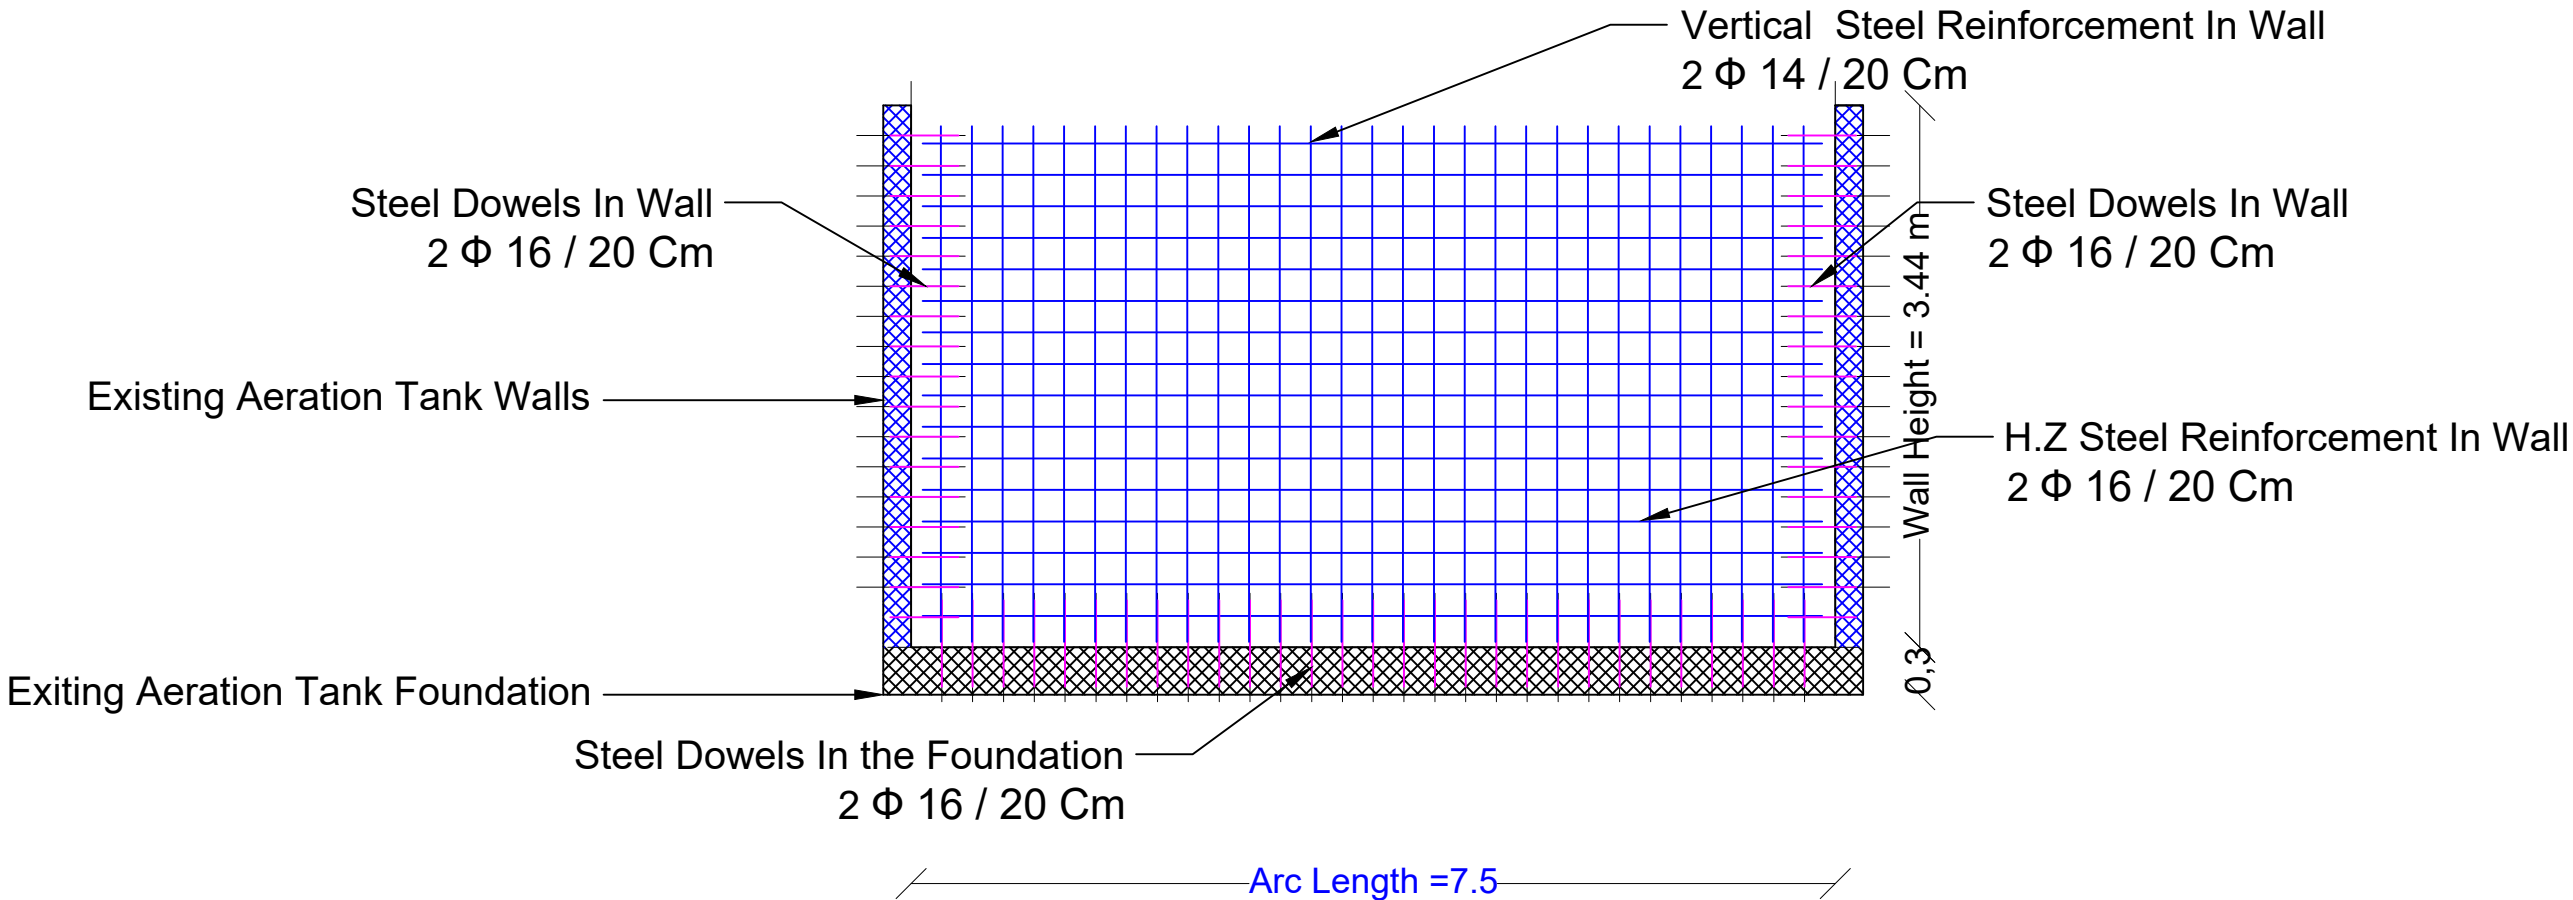

Section A-A

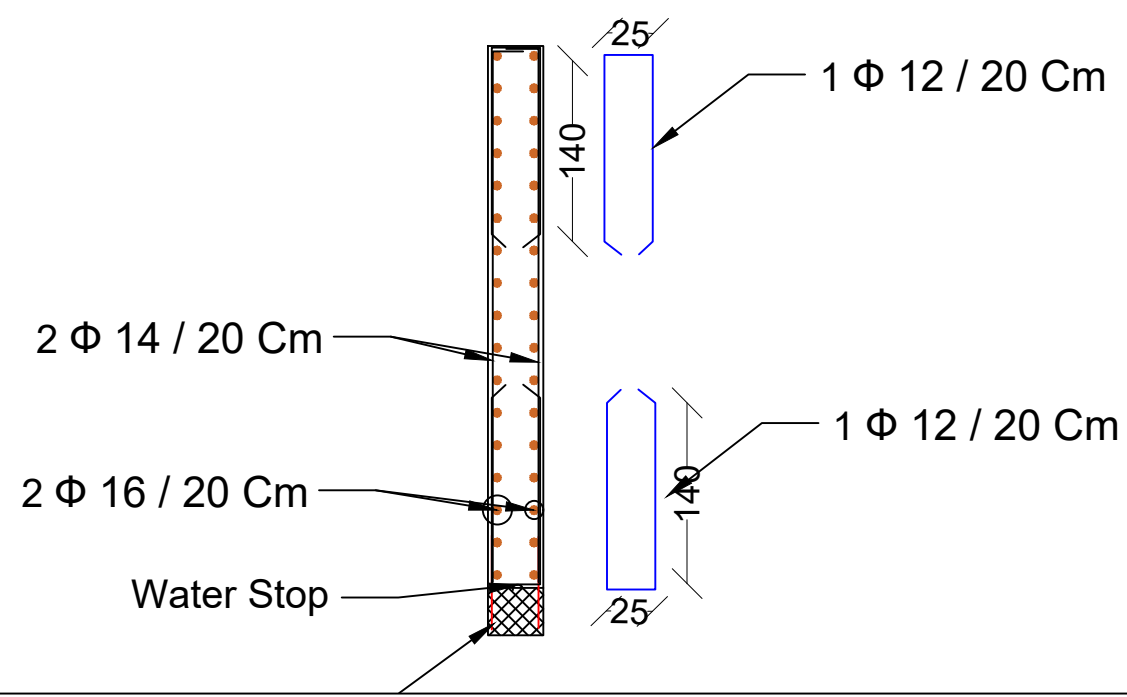

Drawing Name: Kharas WWTP -Section Reinforcement Details - Proposed Design		Date: June, 2025				
Drawing No. KH-EXP-AI-		Scale A3				
Grid Palestine 1923 Palestine Grid		Size A3				
REV	Date	Description	Drawn	Design	Checked	Approved By
1	June 2024	Draft Preliminary Design	H.Dababat			

CLIENT:		Integrated Water Resource Management Phase 2 RFP REF. NO: From Abeer Rehabilitation and Partitioning of Aeration Tank – Kharas WWTP	
Notes:		Supervision: AI Aid for Agricultural Development Sahel Numidia street, Hitech building Ramallah-Palestine	
		In Association With Experts-Solidaires Expert Solidaires Bâtiment B1, Parc Scientifique II Agoopols 2186 Boulevard de la Lirade	

